



FIRST FLOOR PLAN - AREA "A"

F.F.E. = 100'-0"



"AS-BUILT INFORMATION HAS BEEN INCORPORATED ON THIS DRAWING."
DATED: MAY 17, 1999. Dale Reidsma.

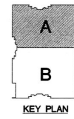

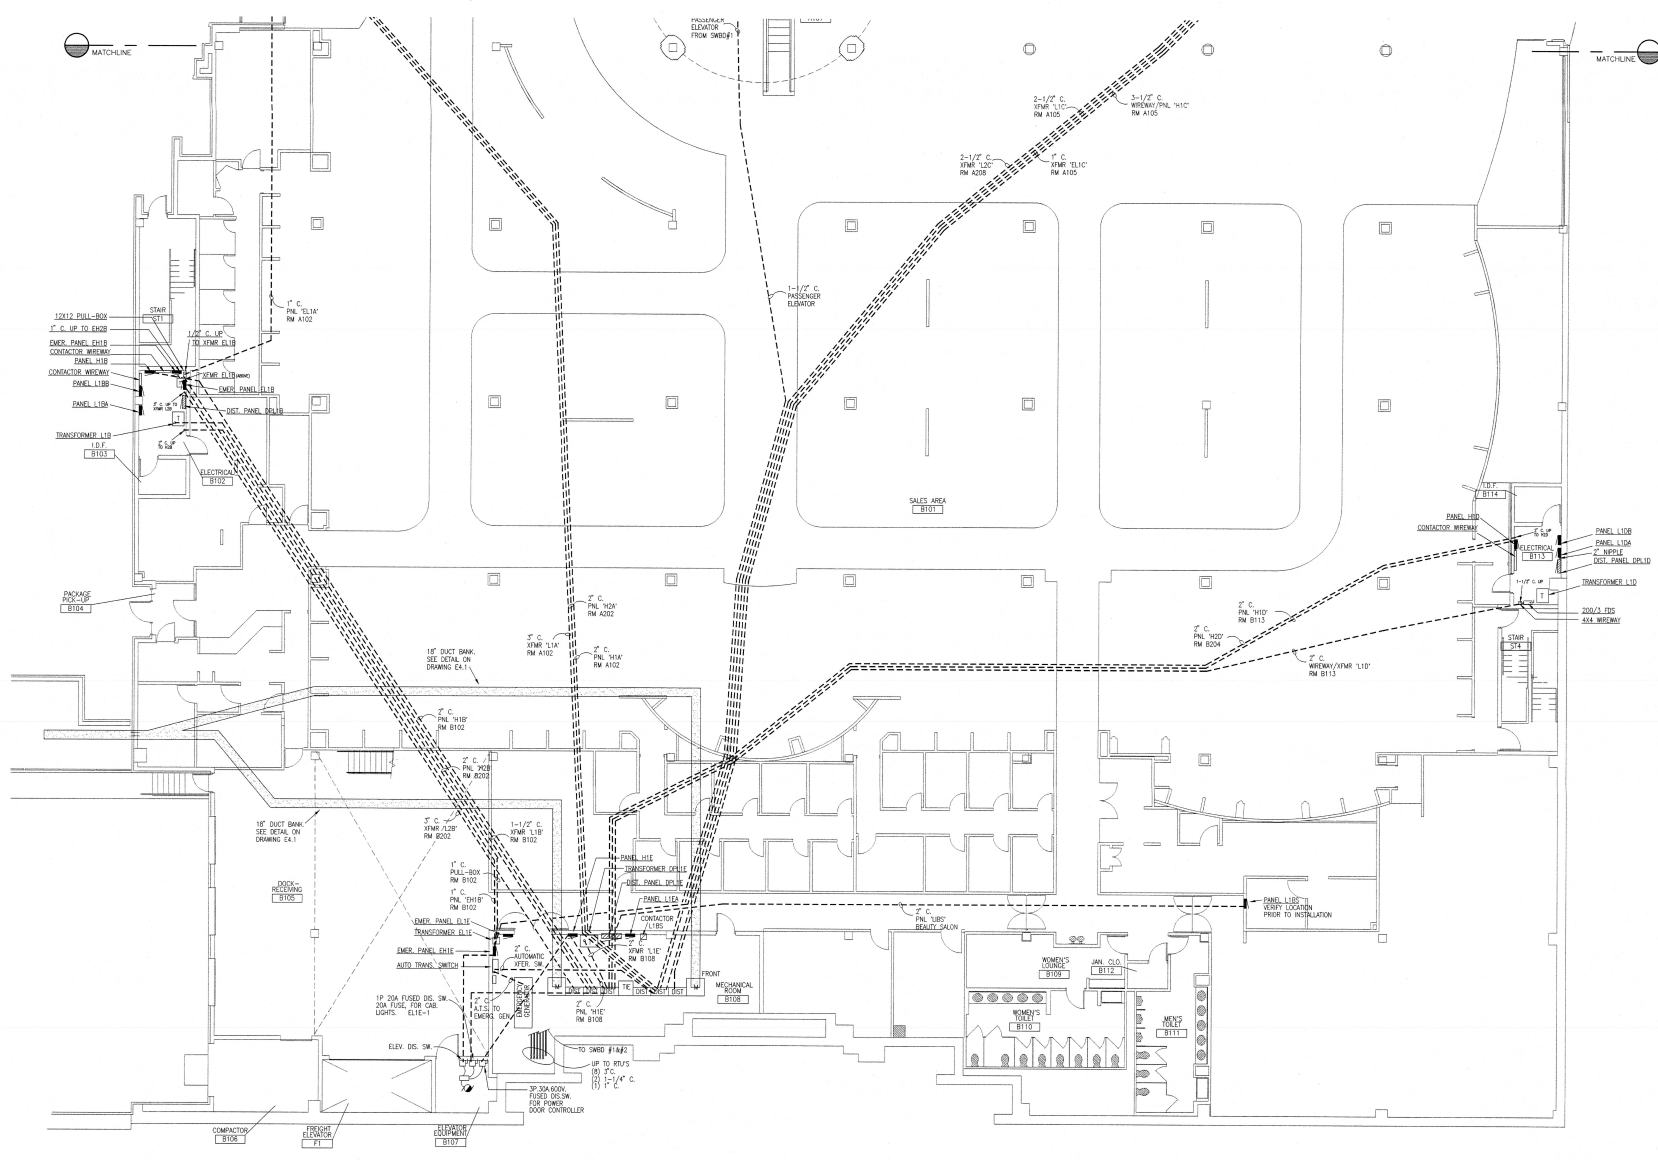

FIRST FLOOR PLAN - AREA "B"



"AS-BUILT INFORMATION HAS BEEN INCORPORATED ON THIS DRAWING."
 DATED: MAY 17, 1999. Dale Reidsma.

